


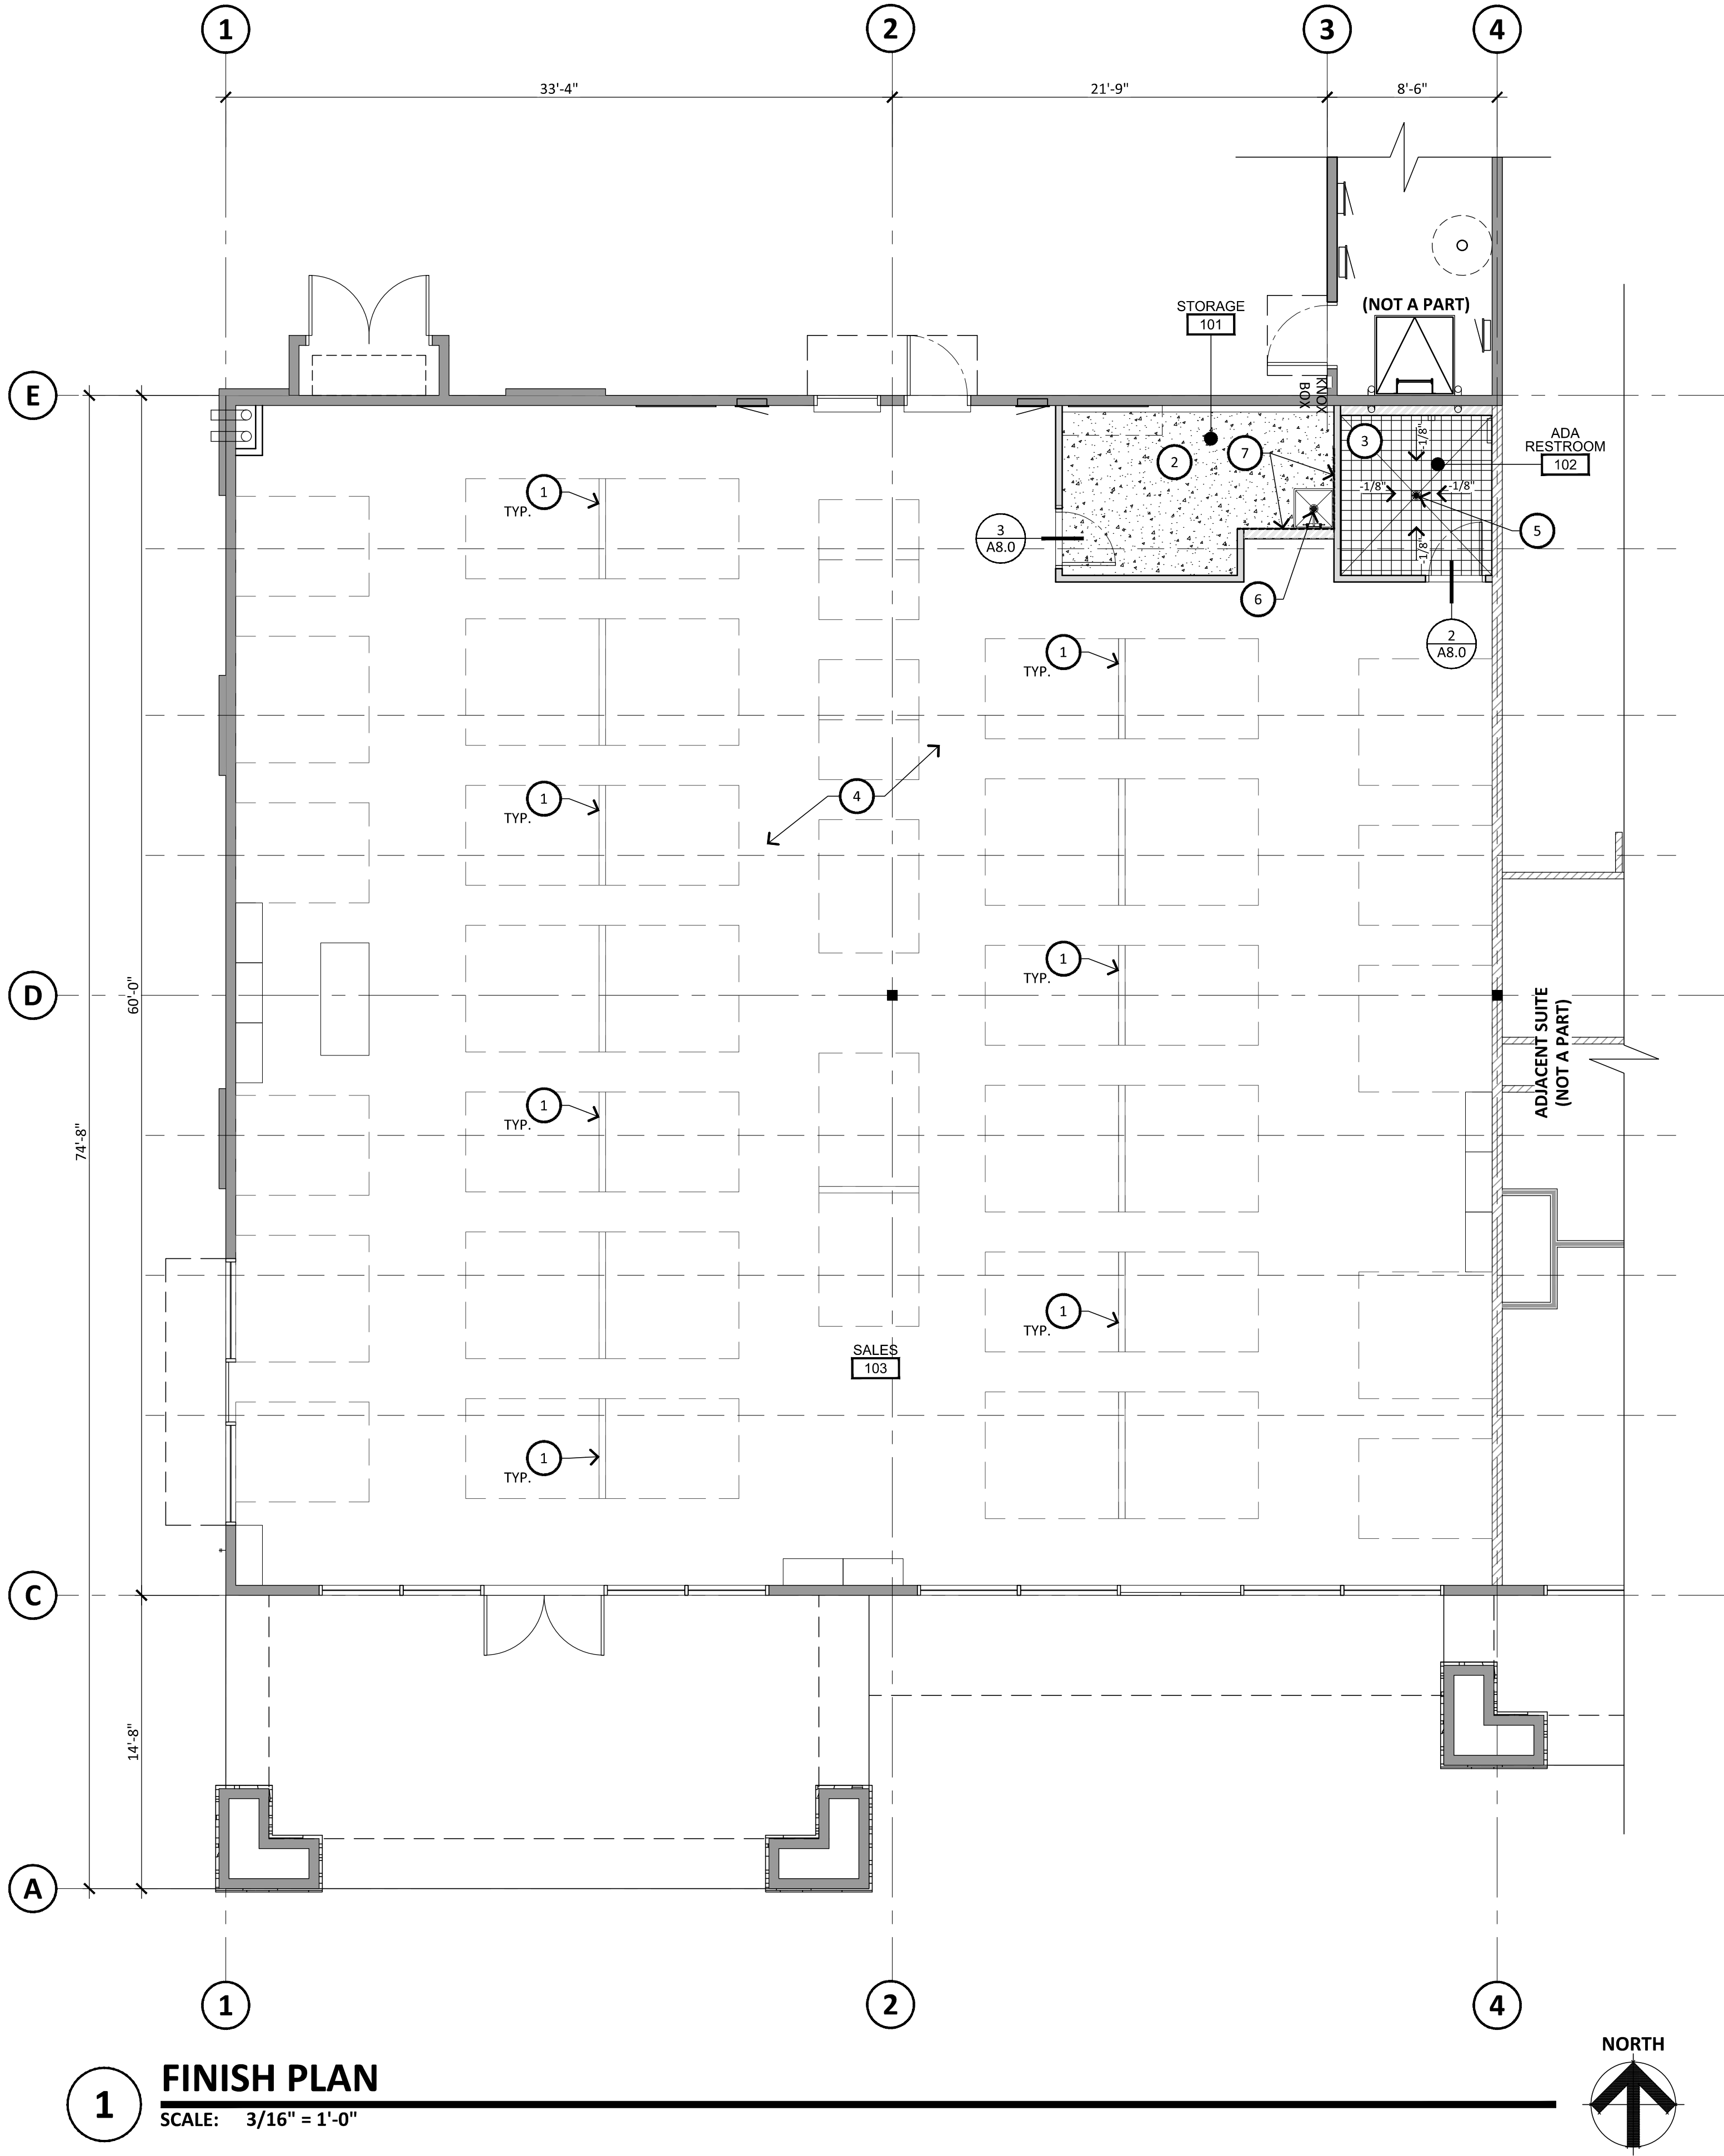

JOHN TO
PROVIDE THIS
TILES AND
INFORMATION

LUXURY VINYL TILE 9 X 60
PANTHEON - MEADOW,
COLOR: IVORY TUSK

PORCELAIN TILE 24 X 24
ARIZONA TILE - PIETRA ITALIA,
COLOR: GREY, GROUT LINES
MATCH MAPEI 02 PEWTER

LUXURY VINYL TILE 9 X 60
PANTHEON - MEADOW,
COLOR: IVORY TUSK

KEYNOTES


1. NEW LOW WALL, RE: A1.0 (FLOOR PLAN)
2. NEW SEALED CONCRETE FLOORING WITH TRANSITION STRIP BETWEEN ROOMS
3. NEW TILE FLOORING WITH TRANSITION STRIP BETWEEN ROOMS; G.C. TO DEPRESS FLOOR, RE: A1.1 (ENLARGED RESTROOM PLAN)
4. NEW LUXURY VINYL TILE WITH TRANSITION STRIP BETWEEN ROOMS, OWNER TO PROVIDE
5. NEW 6x6 FLOOR DRAIN
6. NEW MOP SINK
7. DASHED LINE INDICATES 4'-0" x 4'-0" WHITE FRP PANEL ON WALL

LEGEND



#	—	DETAIL REFERENCE
#	—	SHEET NUMBER
#		GRID LINE NUMBER
ROOM NAME	XXX	ROOM NAME

ADD WALL PAINT FINISHES AND BASE PER PROTOTYPE

OKAY SMALL SCHEDULE FOR PAINT

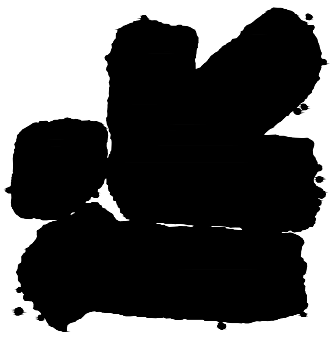

IRKAA
ARCHITECTS
2233 EAST THOMAS ROAD, PHOENIX, ARIZONA 85016
602-955-3900
IRKAA.com

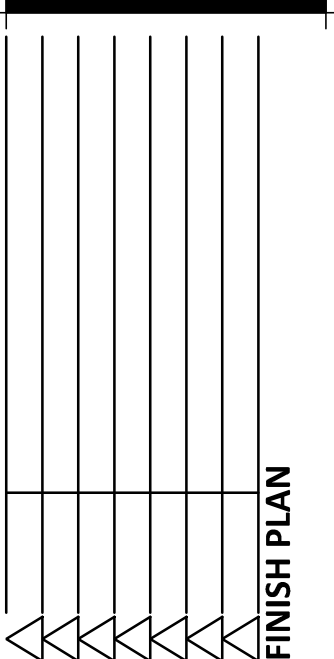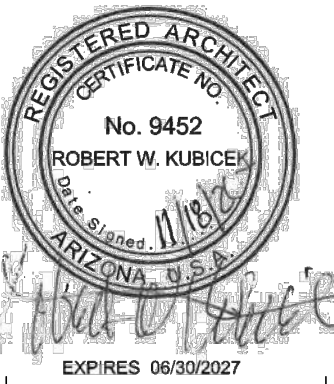

NOTICE OF ALTERNATE BILLING OR PAYMENT CYCLE:
THIS CONTRACT MAY ALLOW THE OWNER TO REQUIRE
THE SUBMISSION OF BILLING OR ESTIMATES IN
BILLING CYCLES OTHER THAN THIRTY DAYS. THIS
CONTRACT MAY ALLOW OWNER TO HAVE A SHORTER
BILLING CYCLE. THE BILLING CYCLE SHALL BE
CERTIFICATION AND APPROVAL OF BILLING AND
ESTIMATES. A WRITTEN DESCRIPTION OF EACH CYCLE
BILLING CYCLE APPLICABLE TO THE PROJECT IS
AVAILABLE FROM OWNER OR DESIGNATED AGENT.
NAME:
ADDRESS:
CONTACT: Name:
PHONE:

BROOKLYN BEDDING
PAD 5B - SUITES 101 AND 102 AT PASEO LINDO SHOPPING CENTER
NEC OF ARIZONA AVE AND OCOTILLO RD.
CHANDLER, AZ

COPYRIGHT 2023, ALL RIGHTS RESERVED. THIS
DRAWING IS AN INSTRUMENT OF SERVICE. IT IS THE
PROPERTY OF IRKAA ARCHITECTS, INC. AND MAY NOT BE
REPRODUCED OR REPRODUCTION HEREOF, WHOLLY
WITHOUT WRITTEN PERMISSION OF THE
COMPANITION.

design by: RH
drawn by: MM
checked by: RH

A1.3
project #: 26102.00