


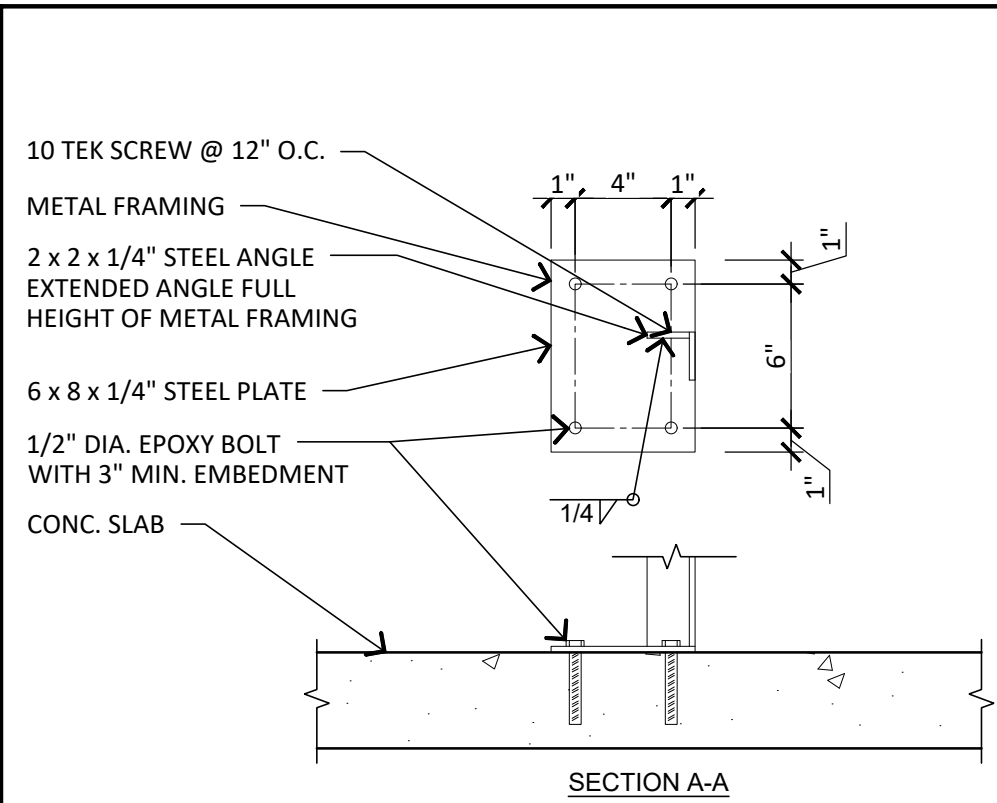


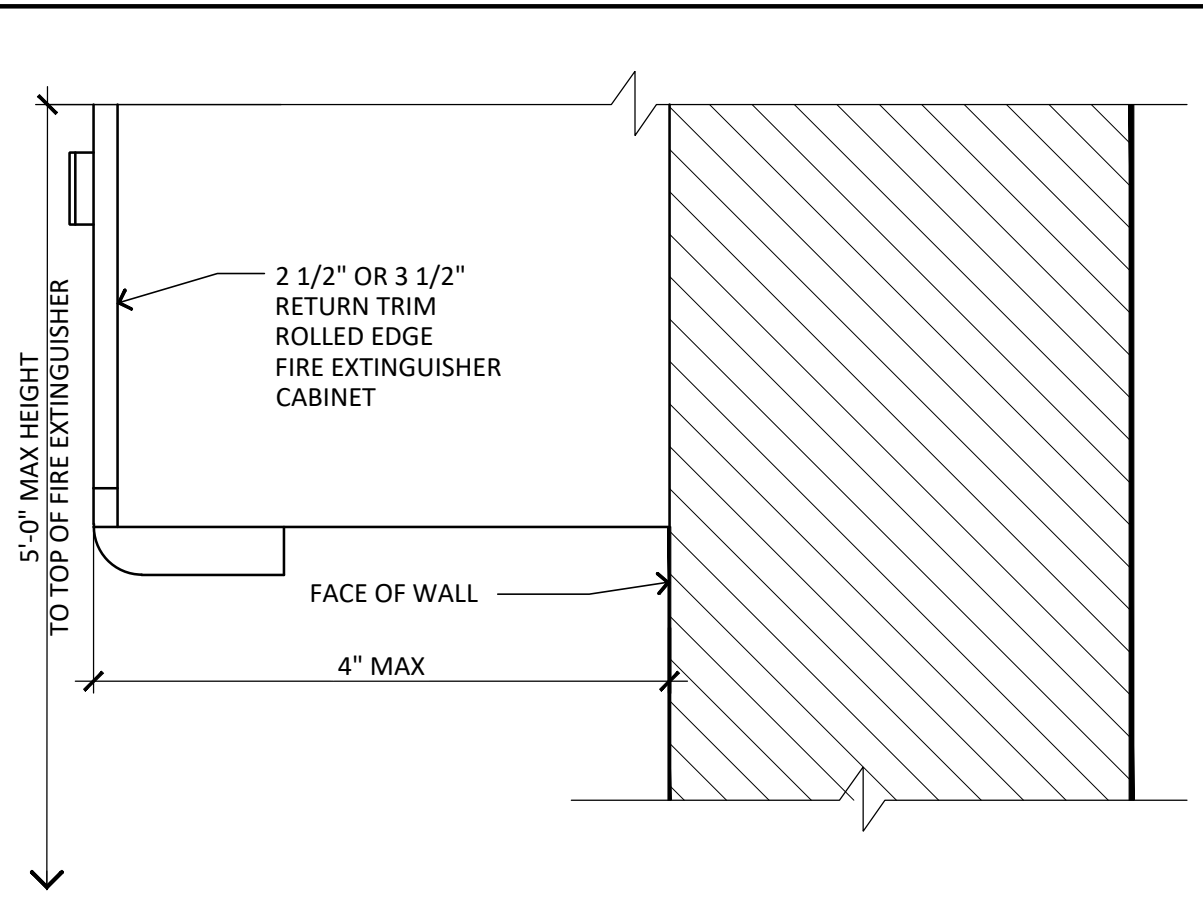


9 HALF WALL
SCALE: 1 1/2'-0" = 1'-0"

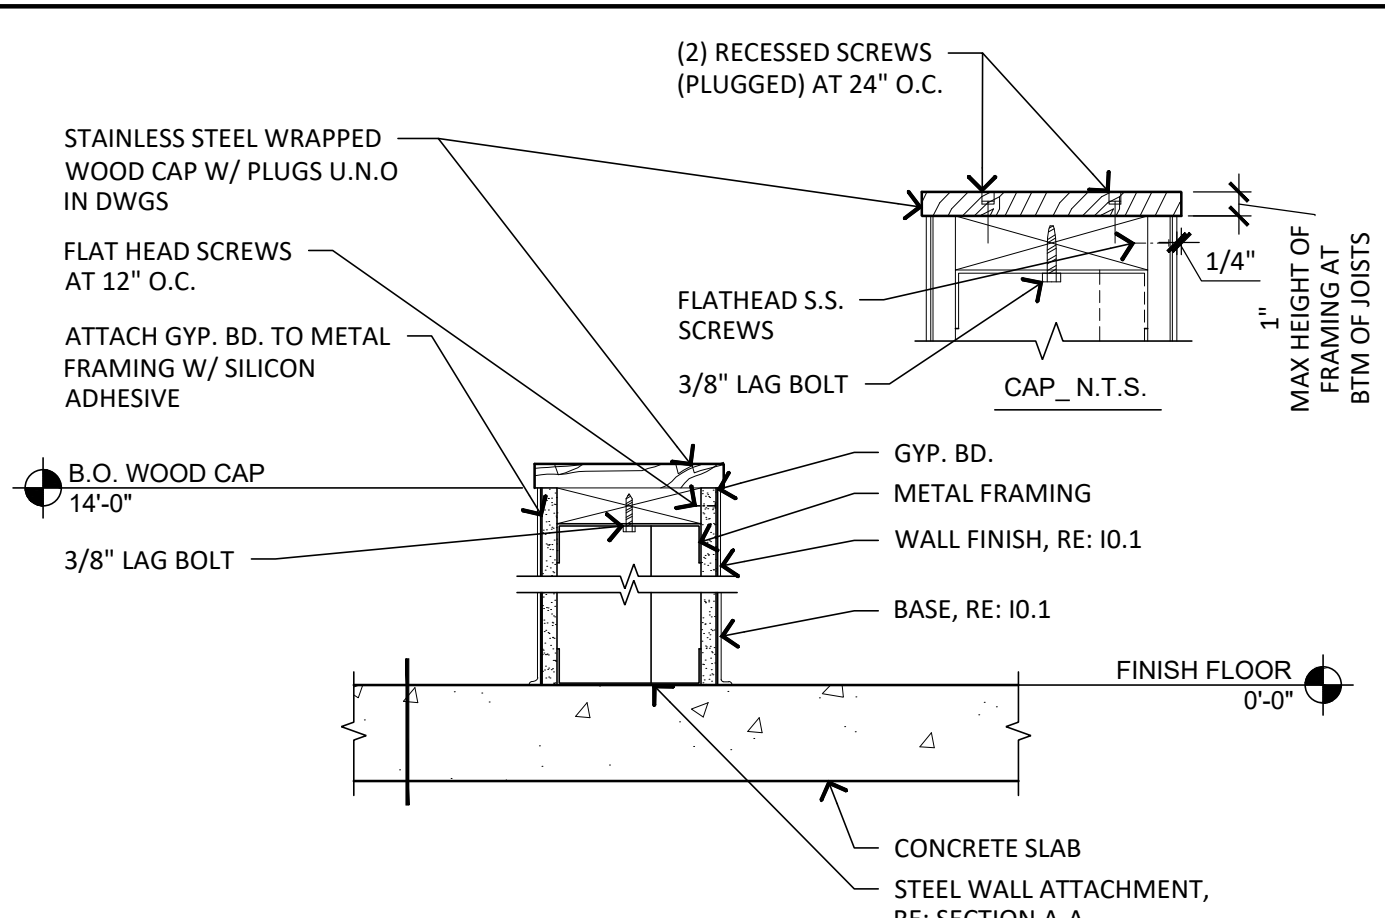


1 SURFACE MTD. FIRE EXTINGUISHER CAB.
SCALE: N.T.S.

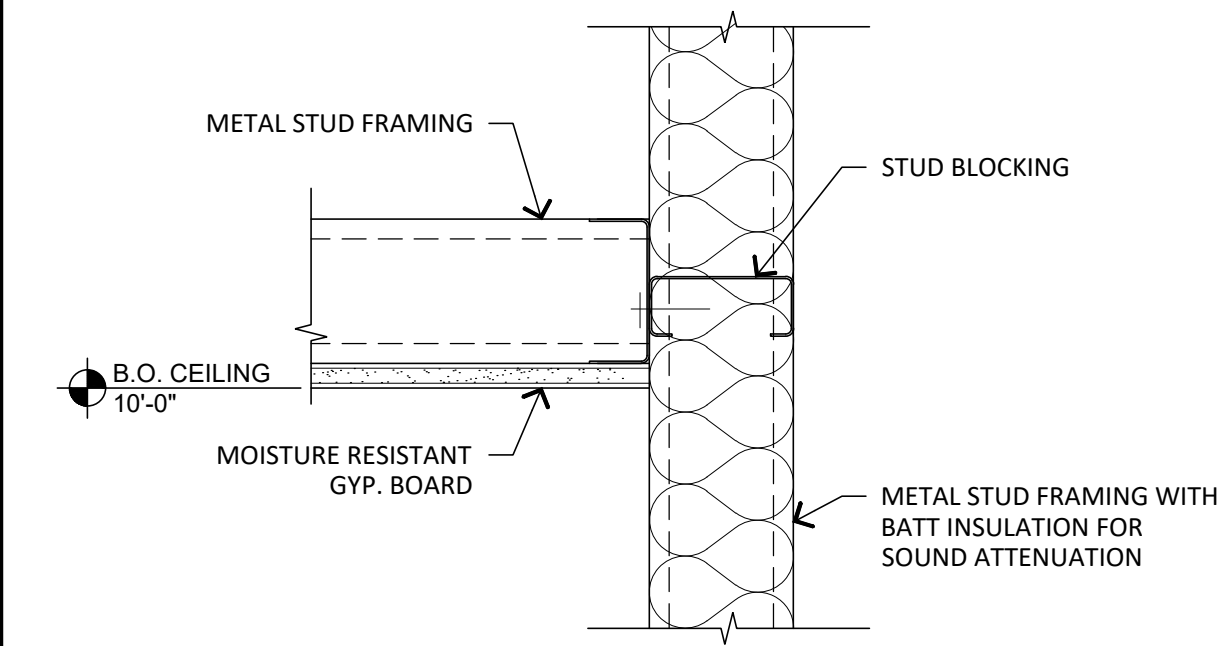

10 GYP. CEILING AT WALL
SCALE: 1 1/2'-0" = 1'-0"

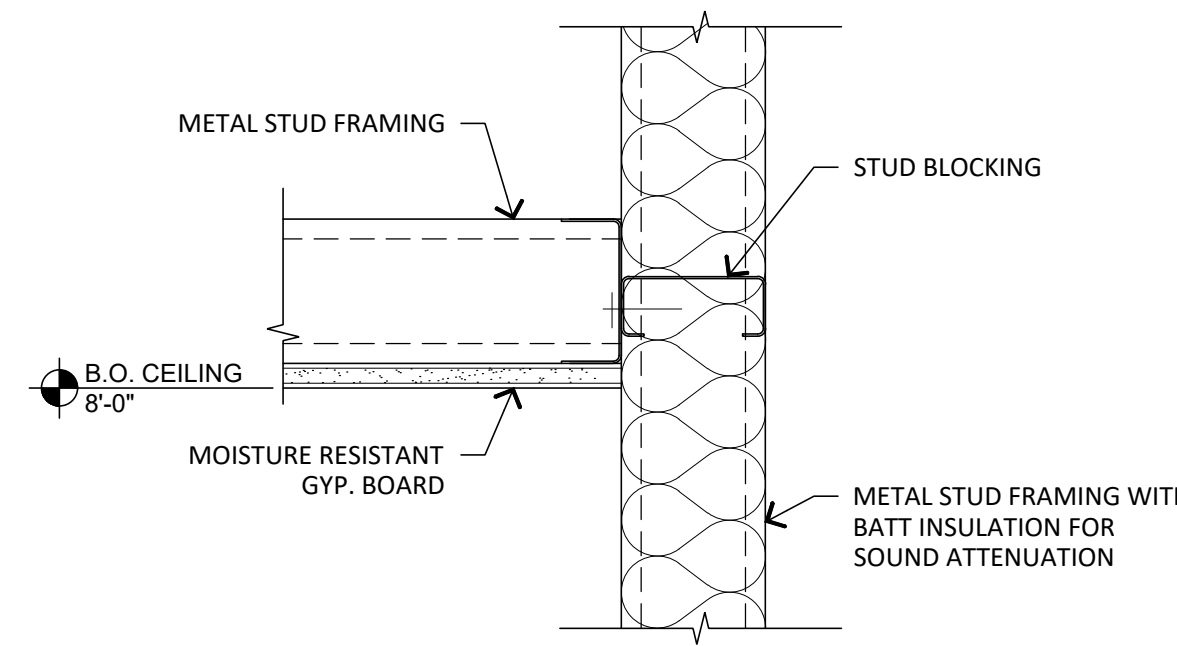


6 GYP. CEILING AT WALL
SCALE: 1 1/2'-0" = 1'-0"

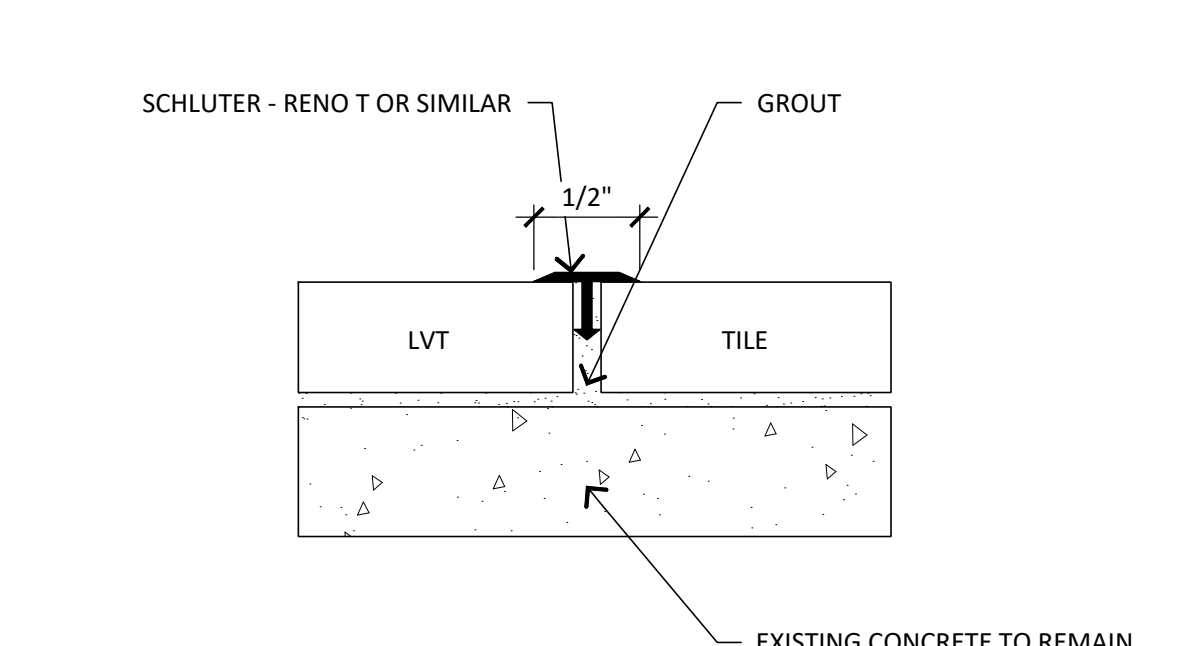


2 FLOOR TRANSITION; LVT TO TILE
SCALE: 1'-0" = 1'-0"

ADD CEILING DETAILS FOR HANGING OVAL

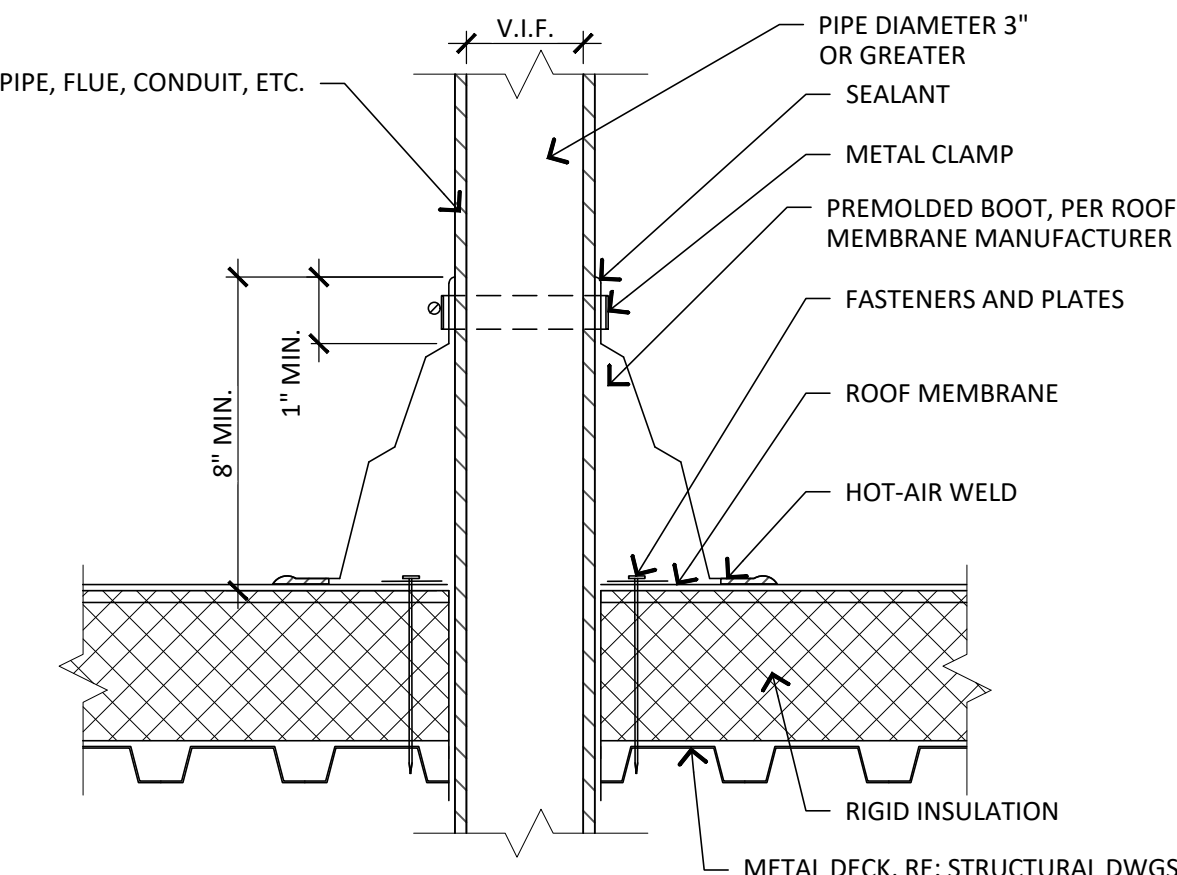


7 PIPE FLASHING - PRE MOLDED
SCALE: 1 1/2'-0" = 1'-0"

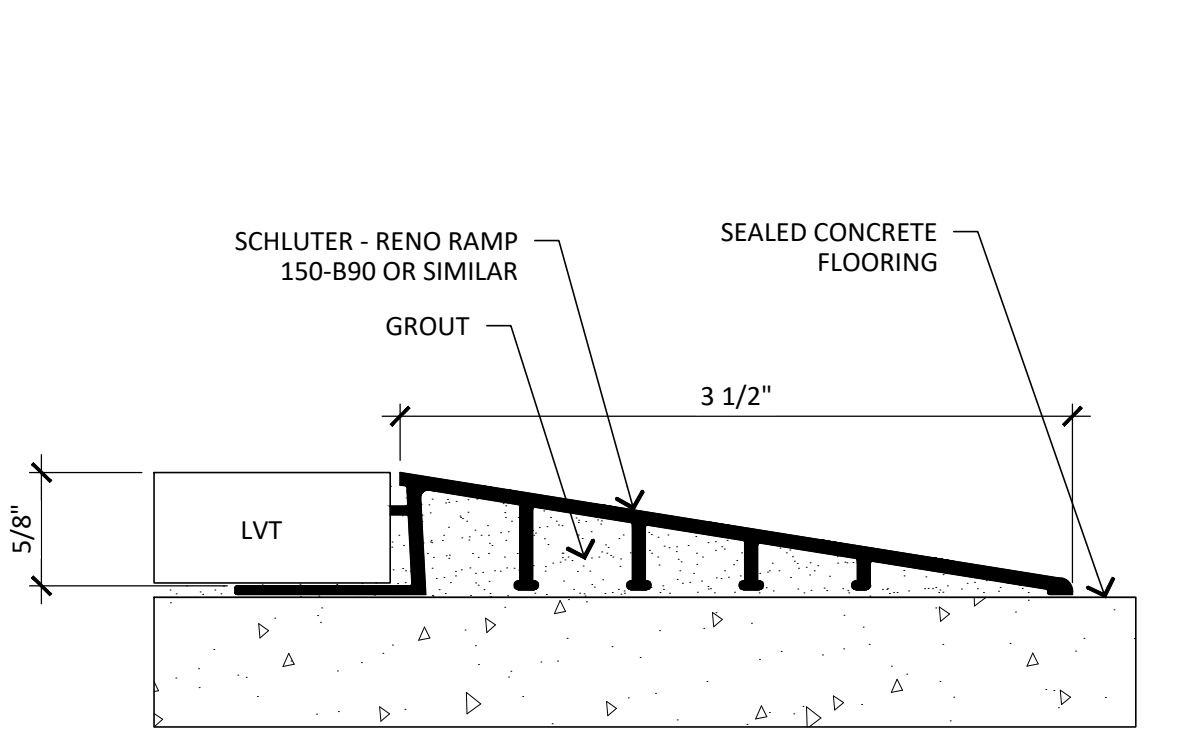

3 FLOOR TRANSITION; LVT TO CONCRETE
SCALE: 1'-0" = 1'-0"

P.O.S. COUNDER DOES NOT MATCH PROTOTYPE

RKAA TO SNIP
DETAILS HERE.

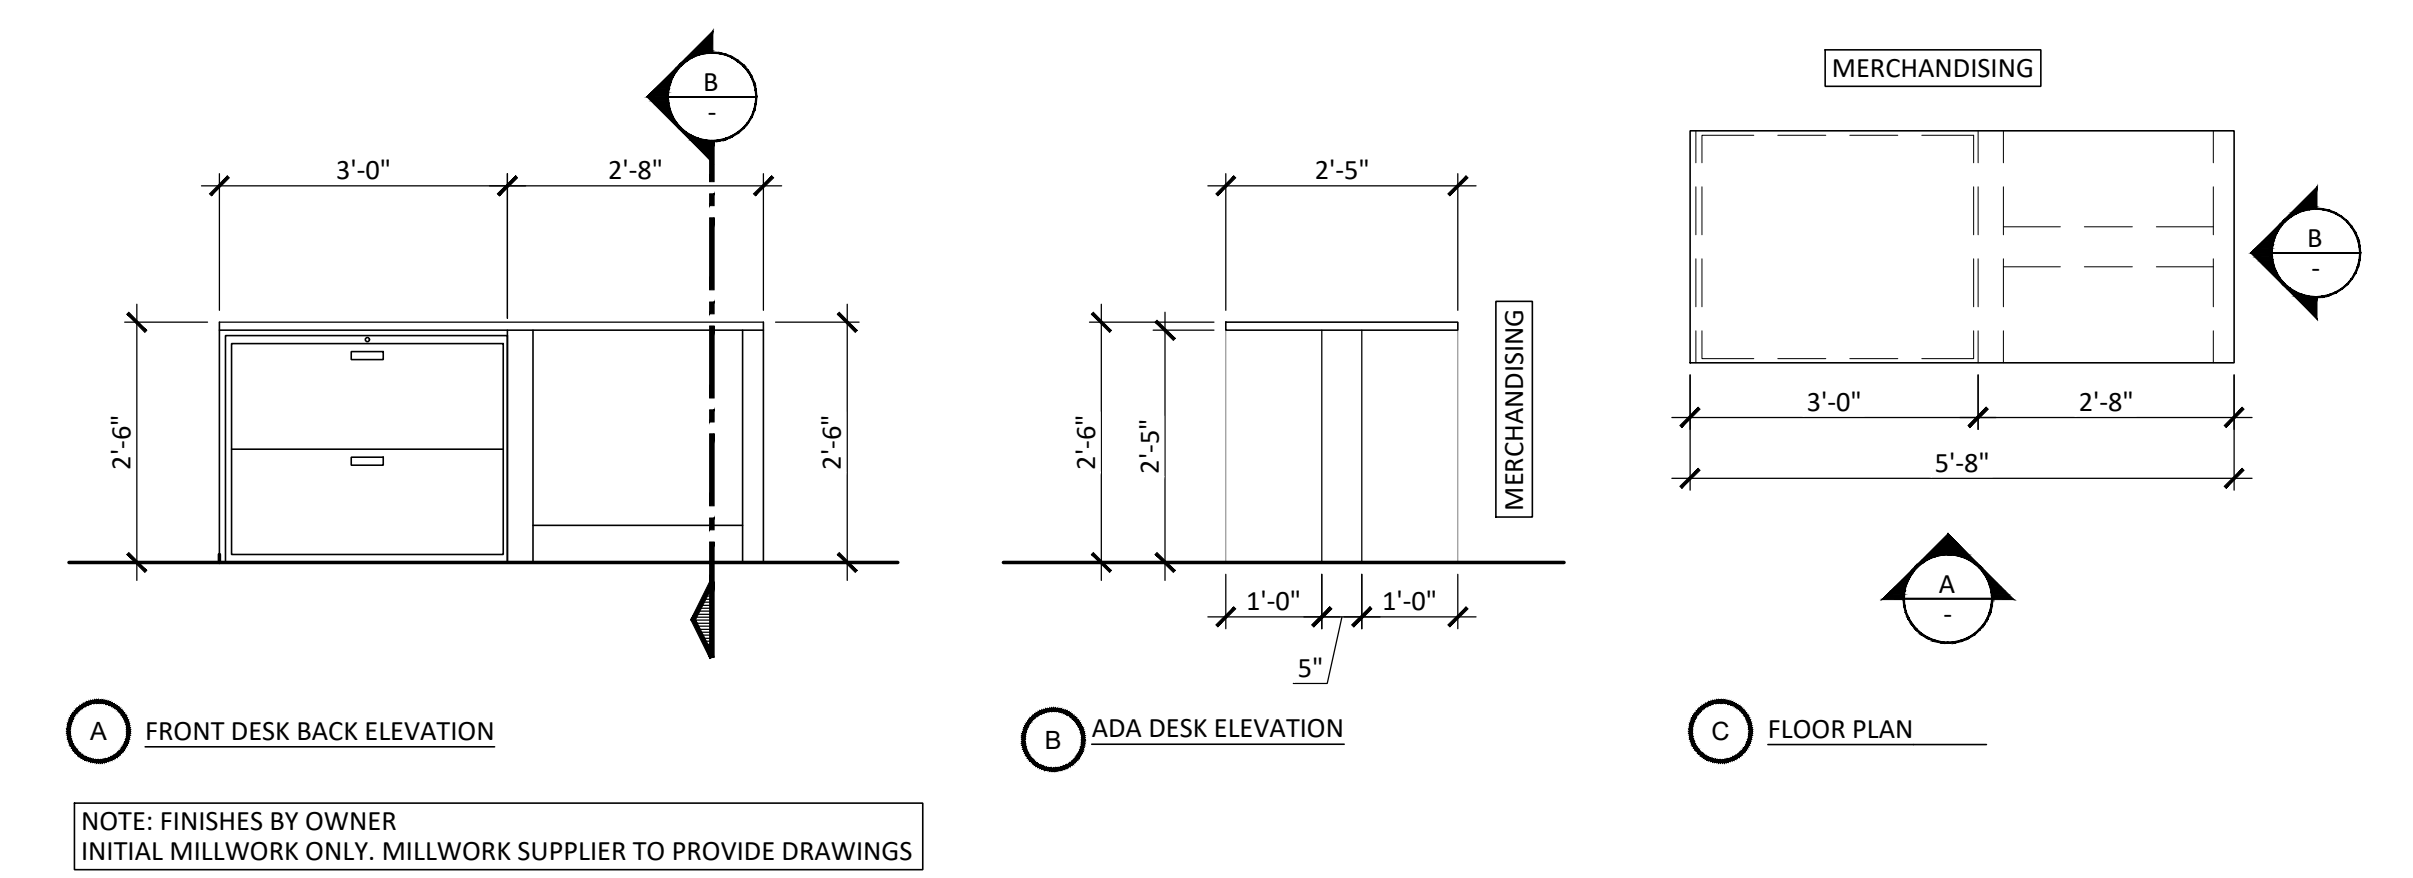

8 P.O.S. MILLWORK
SCALE: 3/8" = 1'-0"